
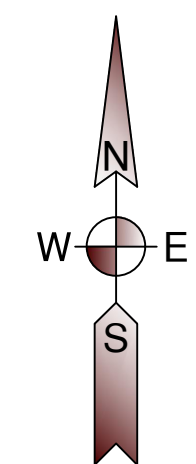



- NOTES:**
1. THIS DRAWING WAS COMPILED FROM INFORMATION PROVIDED BY WANZEK, UTILIZING INFORMATION FROM THE FOLLOWING FILE LIST.
    - a. CRM\_AvoidanceBuffer\_110813.SHX
    - b. USFWS\_WetEas\_1012.SHX
    - c. Wetlands\_Poly\_102314.SHX
    - d. Courtney\_TurbineArrayRenumbering\_2015\_07\_15.SHX
    - e. Courtney\_ALTA\_150120.DWG
    - f. Courtney\_CollectionRecordLines\_20161108.SHP
    - g. Courtney\_AdditionalSurveyCorridor\_2015\_10\_07.kmz
  2. THE AERIAL WAS OBTAINED BY ULTEIG.
    - g. CourtneyAerial\_NDStateplane\_HarnNAD83\_South\_Inflt.SID

## LEGEND

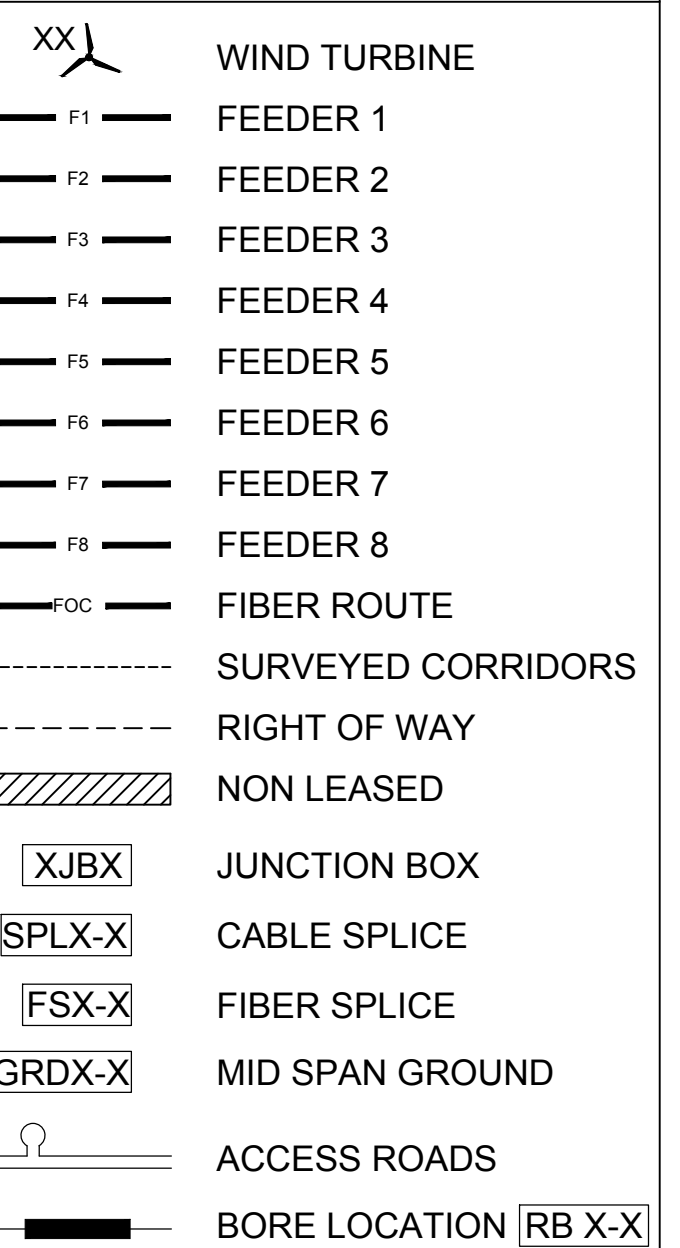

**RECORD DRAWING**  
DRAWINGS ARE BASED UPON  
CONSTRUCTION CONTRACTOR REDLINES  
WHICH HAVE NOT BEEN FIELD VERIFIED BY  
ENGINEER OF RECORD.

NO	REVISION	ZONE	DATE	BY	CHK	ENG	NO	REVISION	ZONE	DATE	BY	CHK	ENG	REFERENCE DRAWINGS			<div><p>NORTHERN STATES POWER COURTENAY WIND - COLLECTION SYSTEM STUTSMAN COUNTY, NORTH DAKOTA</p><table><tr><td>DWN: MJ</td><td>DATE: 01/22/2016</td><td>CHK:</td><td>DATE:</td></tr><tr><td>ENG: BG</td><td>DATE: 01/22/2016</td><td>CHK:</td><td>DATE:</td></tr><tr><td>PM: BD</td><td>DATE: 01/22/2016</td><td>PROJ. NO: 121901101</td><td></td></tr><tr><td>APVD:</td><td>DATE:</td><td>SCALE: NONE</td><td></td></tr></table></div> <div>THIS MAP/DOCUMENT IS A TOOL TO ASSIST EMPLOYEES IN THE PERFORMANCE OF THEIR JOBS. YOUR PERSONAL SAFETY IS PROVIDED FOR BY USING SAFETY PRACTICES, PROCEDURES, AND EQUIPMENT AS DESCRIBED IN THE SAFETY TRAINING PROGRAMS AND MANUALS.</div>	DWN: MJ	DATE: 01/22/2016	CHK:	DATE:	ENG: BG	DATE: 01/22/2016	CHK:	DATE:	PM: BD	DATE: 01/22/2016	PROJ. NO: 121901101		APVD:	DATE:	SCALE: NONE		UNIT 0	
DWN: MJ	DATE: 01/22/2016	CHK:	DATE:																																
ENG: BG	DATE: 01/22/2016	CHK:	DATE:																																
PM: BD	DATE: 01/22/2016	PROJ. NO: 121901101																																	
APVD:	DATE:	SCALE: NONE																																	
														DWG NO.	MANUFACTURER	DESCRIPTION		FEEDER ROUTING DIAGRAM SECTION 15, T143N, R63W																	
A	90% SUBMITTAL		10/12/2015	MJ	JH	BG																													
0	ISSUED FOR CONSTRUCTION		01/22/2016	AS	JH	BG																													
1	REVISED KEY MAP		02/10/2016	CL	JH	BG																													
2	UPDATED CORRIDORS		06/07/2016	BG	JH	BG																													
3	RECORD DRAWING		12/05/2016	GP	JH	BG																													
																	ENERGY SUPPLY ENGINEERING & CONSTRUCTION	NH-271536-25	REV 3																